



THROUGH-PENETRATION FIRESTOP SYSTEM DETAILS


SYSTEM NO. CAJ1044 T RATING - 0 HR L RATING AT AMBIENT - 2 CFM/SQ FT (SEE ITEM 4) L RATING AT 400 F - LESS THAN 1 CFM/SQ FT (SEE ITEM 4)

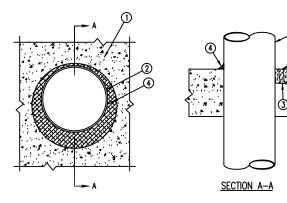


- 1. FLOOR WALL ASSEMBLY-LIGHTWEIGHT OR NORMAL WEIGHT (100-150 PCF) CONCRETE, EXCEPT AS NOTED IN TABLE UNDER ITEM 4. MIN THICKNESS OF SOLID CONCRETE FLOOR OR WALL ASSEMBLY IS 4-1/2 IN. FLOOR MAY ALSO BE CONSTRUCTED OF ANY MIN 6 IN. THICK UL CLASSIFIED HOLLOW-CORE. PRECOAT CONCRETE UNITS. WHEN FLOOR IS CONSTRUCTED OF HOLLOW-CORE PRECOAT CONCETE UNITS, PACKING MATERIALS (ITEM 3) AND CAULK FILL MATERIAL (ITEM 4) TO BE INSTALLED SYMETRYCALLY ON BOTH SIDES OF THE FLOOR, FLUSH WITH FLOOR SURFACE. WALL ASSEMBLY MAY ALSO BE CONSTRUCTED OF CLASSIFIED CONCRETE BLOCKS. MAX DIA. OF OPENING IS 32 IN. SEE CONCTRETE BLOCKS (CAZT) AND PRECAST CONCRETE UNITS (CFTV) CATEGORY IN THE FIRE RESISTANCE DIRECTORY FOR NAMES OF MANUFACTURER
- 1A. STEEL SLEVE (OPTIONAL NOT SHOWN) NOM 16 IN. (OR SMALLER) SCHEDULE 10 (ORHEAVIER) STEEL SLEEVE CAST OR GROUTED INTO FLOOR OR WALL ASSEMBLY. SLEEVE MAY EXTEND A MAX OF 2 IN. ABOVE TOP FLOOR OR BEYOND EITHER SURFACE OF WALL. 2. PIPE OR CONDUIT - NOM 30 IN.DIA. (OR SMALLER) CAST IRON OR SCHEDULE 10 (OR HEAVIER) STEEL
- PIPE, NOM 6 IN. DIA. (OR SMALLER) STEEL CONDUIT, NOM 3 IN. DIA. (OR SMALLER) TYPE L (OR HEAVIER) COPPER TUBE OR NOM 4 IN. DIA. (OR SMALLER) STEEL ELECTRICAL METALIC TUBING, MAX ANNU;AR SPACE BETWEEN PIPE OR CONDUIT AND EDGE OF THROUGH OPENING NOT TO EXCEED 2 IM. MIN ANNULAR SPACE BETWEEN PIPE OR CONDUIT AND EDGE OF THROUGH OPENING IS 0 IN. (POINT CONTACT). PIPE OR CONDUIT TO BE RIGIDLY SUPPORTED ON BOTH SIDE OF FLOOR OR WALL ASSEMBLY. 3. PACKING MATERIAL - POLYETHYLENE BACKER ROD OR NOM 1 IN. THICKNESS OF THIGHTLY-PACKRD MINERAL
- WOOL BATT OR GLASS FIBER INSULATION FIRMLY PACKED INTO OPENING AS A PERMANENT FORM. PACKING MATERIAL TO BE RECESSED FROM TOP SURFACE OF FLOOR OF FROM BOTH SURFACES OF WALL AS REQUIRED TO ACCOMODATE THE REQUIRED THICKNESS OF CAULK FILL MATERIAL (ITEM 4). 4. FILL, VOID OR CAVITY MATERIAL - CAULK - APPLIED TO FILL THE ANNULAR SPACE FLUSH WITH TOP SURFACE OF FLOOR. IN WALL ASSEMBLIES, REQUIRED CAULK THICKNESS TO BE INSTALLED SYMMETRICALLY ON BOTH SIDES OF WALL, FLUSH WITH WALL SURFACE. THE HOURLY F RATING AND THE MIN REQUIRED CAULK
- THICKNESS ARE DEPENDENT UPON A NUMBER OF PARAMETERS, AS SHOWN ON THE FOLLOWING TABLE. TUBE OR CONDUIT ANNULAR SPACE, IN
- (b) MIN 1 IN. THICKNESS OF MINERAL—WOOL BATT INSULATION REQUIRED IN ANNULAR SPACE ON BOTH SIDES OF FLOOR OR WALL ASSEMBLY. MIN 1 IN. THICKNESS OF CAULK TO BE INSTALLED FLUSH WITH EACH SURFACE
- MINNESOTA MINING & MANUKACTURING CO TYPES CP-25 WB, CP-25 WB+. (NOTE: L RATING AND OR USE OF OPTIONAL SLEEVE APPLY ONLY WHEN TYPE CP-25WB+ CAULK IS USED).

SYSTEM NO. CAJ1027 F RATING - 3 HOUR T RATING - 0 HOUR

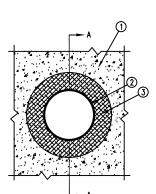


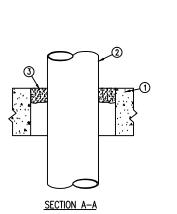

- . FLOOR OR WALL ASSEMBLY MIN 4-1/2 IN. THICK LIGHTWEIGHT OR NORMAL WEIGHT CONCRETE. WALL MAY ALSO BE CONSTRUCTED OF ANY UL CLASSIFIED CONCRETE BLOCKS. MAX THROUGH OPENING SIZE
- SEE CONCRETE BLOCKS (CAZT) CATEGORY IN FIRE RESISTANCE DIRECTORY FOR NAMES OF MANUFACTURERS. PIPE OR CONDUIT - NOM. 10 IN. DIA. (OR SMALLER) SCHEDULE 10 (OR HEAVIER) STEEL PIPE, NOM 6 IN. DIA. (OR SMALLER) RIGID STEEL CONDUIT, NOM 4 IN. DIA. (OR SMALLER) STEEL EMT OR NOM 3 IN. DIA. (OR SMALLER). TYPE L (OR HEAVIER) COPPER PIPE. MAX ONE PIPE OR CONDUIT PER THROUGH OPENING. MAX ANNULAR SPACE BETWEEN PIPE OR CONDUIT AND EDGE OF OPENING IS 3/4 IN. MIN ANULAR SPACE BETWEEN PIPE OR CONDUIT AND EDGE OF OPENING IS 0 IN. (POINT CONTACT). PIIPE OR CONDUIT TO BE RIGIDLY SUPPORTED ON BOTH SIDES
- 3. FILL VOID OR CAVITY MATERIALS PUTTY—MOLDABLE PUTTY MATERIAL KNEEDED BY HAND AND APPLIED TO FILL ANNULAR SPACE TO A MIN DEPTH OF 1 IN FLUSH WITH TOP SURFACE OF FLOOR. IN WALL ASSEMBLIES, REQUIRED PUTTTY THICKNESS TO BE INSTALLED SYMMETRICALLY ON BOTH SIDES OF WALL. MINNESOTA MINING & MFG. CO.- MPS-2+. *BEARING THEUL CLASSIFICATION MARKING.

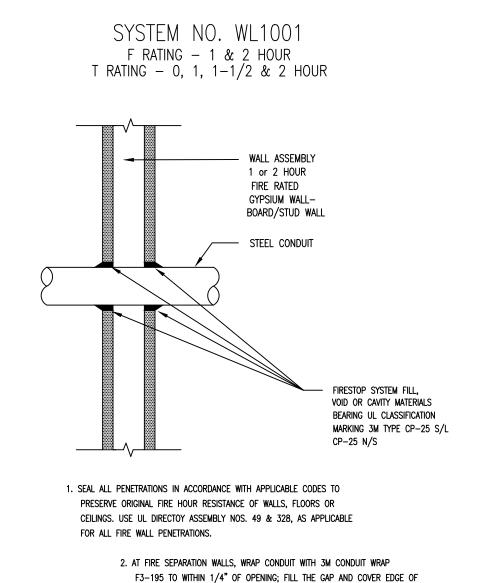

WRAP WITH 3M-CP25 CAULK AND/OR #303 PUTTY.

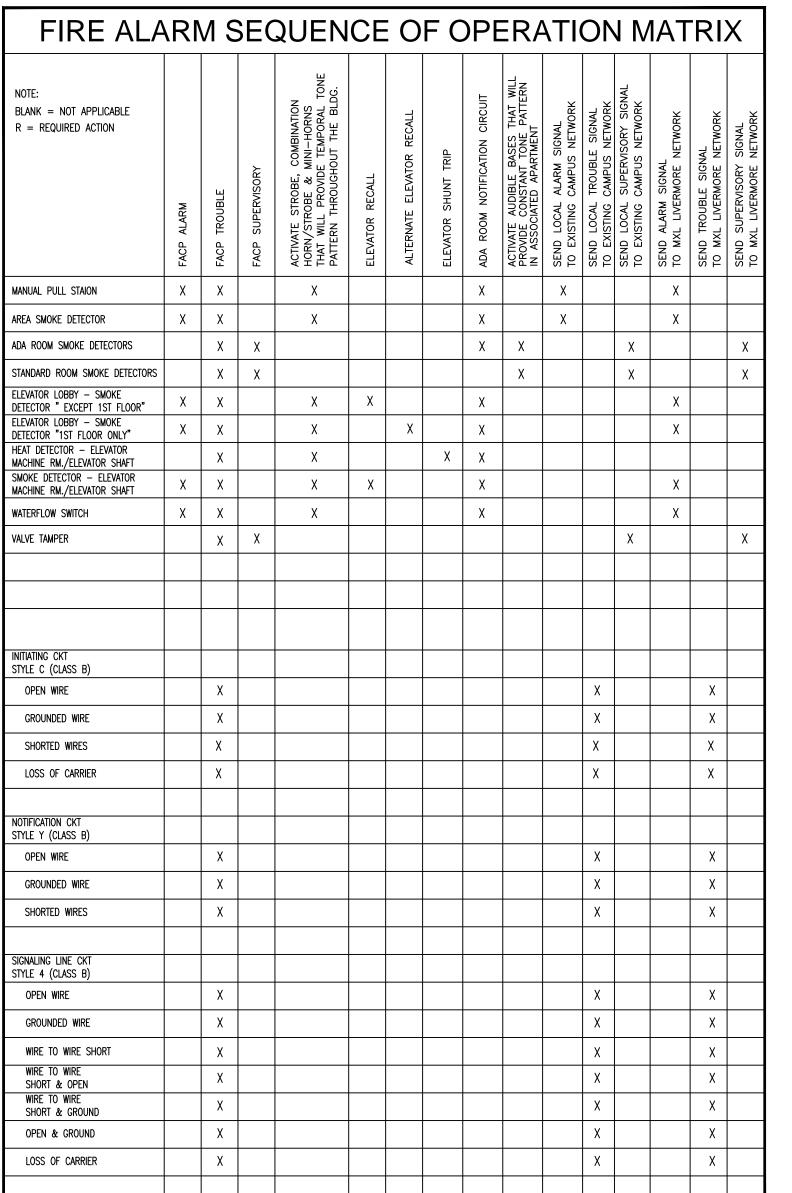

SEQUENCE OF OPERATIONS SUMMARY FOR AREA & ADA ROOM SMOKE DETECTORS

AREA SMOKE DETECTOR

ACTUATION OF ANY AREA SMOKE DETECTORS SHALL SEND ALARM SIGNALS TO FIRE ALARM CONTROL PANEL, TO EXISTING CAMPUS NETWORK SYSTEM AND TO LIVERMORE EXISTING NETWORK SYSTEM. IT WILL ACTIVATE THE BUILDING FIRE ALARM SYSTEM INCLUDING THE ADA ROOM NOTIFICATION CIRCUITS BY PROVIDING A TEMPORAL TONE PATTERN.

ADA ROOM SMOKE DETECTOR

ACTUATION OF ANY ADA ROOM SMOKE DETECTORS SHALL SEND SUPERVISORY SIGNALS TO FIRE ALARM CONTROL PANEL, TO EXISTING CAMPUS NETWORK SYSTEM AND TO LIVERMORE EXISTING NETWORK SYSTEM. DEVICE SOUNDER BASE WILL PROVIDE A CONSTANT TONE PATTERN IN ASSOCIATED APARTMENT ROOM ONLY. IT WILL ONLY ACTIVATE THE ROOM NOTIFICATION CIRCUIT BY PROVIDING A TEMPORAL TONE PATTERN BUT WILL NOT ACTIVATE THE BUILDING FIRE ALARM SYSTEM.

DEVICE DESIGNATION LEGEND INITIATING DEVICES EXAMPLES: - DEVICE REFERENCE NUMBER - INITIATING ALD LOOP DESIGNATION - MXL NODE (BUILDING 9) DEVICE SYMBOL (SMOKE DETECTOR) AUDIBLE / VISUAL CIRCUITS: EXAMPLES: — STROBE CANDELA RATING DEVICE REFERENCE NUMBER - VISUAL CIRCUIT DESIGNATION DEVICE SYMBOL (HORN/STROBE)

WIRING SCHEDULE		
WIRE SYMBOL	WIRE DESCRIPTION	USED ON
A	2—CONDUCTOR, #16 AWG SOLID, TWISTED, SHIELDED	ALD ADDRESSABLE LOOP DEVICES (ie. SMOKE/HEAT DETECTOR, TRI-SERIES)
B	2-CONDUCTOR, #12 AWG SOLID or STRANDED	NOTIFICATION APPLIANCE CIRCUIT: - STROBES - MINI HORNS - COMBINATION HORN/STROBES
D	2-CONDUCTOR, #12 AWG SOLID	24 VDC POWER TO: - ICP-B6 - MOM-2
E 	2-CONDUCTOR, #12 AWG SOLID	24 VDC POWER (SUPERVISED) TO: - SOUNDER BASES
G	2-CONDUCTOR, #16 AWG SOLID CABLE	TRI to MONITORED DEVICES: - WATERFLOW SWITCH - VALVE POSITION SUPERVISORY SWITCH - PAD-3 - BACKFLOW VALVE
P 	2-CONDUCTOR, #12 AWG SOLID or STRANDED	PAD-3: - ACTIVATION - HORN SILENCE
X	2-CONDUCTOR, #16 AWG SOLID, TWISTED, SHIELDED CABLE	"X-NET" - GLOBAL NETWORK WIRING -NIM-1W TO FIBER OPTIC MODULE
<u>-///</u> ➤ 120 VAC	2-CONDUCTOR WITH GROUND #12 AWG SOLID, THHN COLOR TO MATCH NEC	120 VAC POWER TO CONTROL PANELS - MXL - WHEELOCK POWER BOOSTER PANELS
	NOTE:	L

- 2. WIRING FOR INITIATING DEVICES IS CLASS B, SITLE 4. 3. SEE WIRING GUIDELINES FOR CABLE TYPE USE.
- 4. CONDUIT FILL < 40%, 3/4" CONDUIT
- 5. WHERE CIRCUIT ARE RUN UNDERGROUND, USE UNDERGROUND RATED CABLE.

NOTE: WIRE SIZES WILL VARY (USUALLY LARGER) TO ACCOMMODATE THE VOLTAGE DROP.

WIRING GUIDELINES

PLENUM CABLE VS. NON-PLENUM

THE NEC RECOGNIZES 3 TYPES OF POWER LIMITED FIRE ALARM CABLING:

FPL - THIS IS A GENERAL USE POWER LIMITED FIRE ALARM CABLE. IT CANNOT BE USED IN A PLENUM SPACE OR FOR RISERS (CABLING BETWEEN FLOORS), CABLE MUST BE IN CONDUIT.

FPLR - THIS IS A POWER LIMITED RISER RATED CABLE THAT CAN BE USED FOR GENERAL PURPOSES OR BETWEEN FLOORS. IT CANNOT BE USED IN A PLENUM SPACE, CABLE MUST BE IN CONDUIT.

FPLP - THIS IS A POWER LIMITED CABLE THAT CAN BE USED IN A PLENUM, RISER, OR FOR GENERAL PURPOSE.

A PLENUM IS ANY AREA USED TO CONDUCT ENVIRONMENTAL AIR. PLENUM SPACES CAN BE DUCTWORK, THE SPACE ABOVE A DROP CEILING, OR BELOW A RAISED FLOOR. BECAUSE THESE SPACES ARE BEING USED FOR THE AIR HANDLING SYSTEM. THERE ARE STRICT RULES THAT MUST BE FOLLOWED TO REDUCE THE RISK OF INTRODUCING TOXIC FUMES IN THE EVENT OF A FIRE. SINCE FIRE ALARM CABLING IS OFTEN INSTALLED EXPOSED, WITHOUT CONDUIT, ABOVE DROP CEILINGS THE CABLING MUST BE RATED FOR USE IN A PLENUM SPACE.

WIRING REQUIREMENTS

- THE DRAIN SHIELD IS A VERY IMPORTANT PART OF THE SYSTEM INSTALLATION. WE WOULD NOT SPECIFY SHIELDED CABLE IF IT WAS NOT NECESSARY. SHIELDS SHOULD BE KEPT CONTINUOUS THROUGHOUT THE CIRCUIT AND KEPT FREE FROM ANY REFERENCE TO EARTH GROUND.
- SHIELDED CABLE CAN BE FPL, FPLR, OR FPLP. SIEMENS INTELLIGENT ADDRESSABLE DEVICES REQUIRE SHIELDED CABLE.
- NOTIFICATION APPLIANCES (I.E. SPEAKER/STROBES, HORNS, ETC.) REQUIRE NON-SHIELDED
- UNDERGROUND CABLE, WHETHER OR NOT INSTALLED IN CONDUIT, SHALL BE LISTED AS UNDERGROUND BURIAL TYPE.
- WIRING IS TO BE INSTALLED POINT TO POINT WITH NO SPLICING.

USED OR DISCLOSED TO OTHERS FOR PROCUREMENT OR OTHER PURPOSE (EXCEPT AS OTHERWISE AUTHORIZED BY CONTRACT WITHOUT WRITTEN PERMISSION OF SIEMENS BUILDING TECHNO-LOGIES, INC.. FIRE SAFETY DIVISION. ALL OTHER REPRODUCTIONS SHALL BEAR THIS NOTICE. REVISIONS By Date App REVISED PER FIRE MARSHAL'S | JPM |2/27/09| KW COMMENTS DATED 02/12/09 JPM |8/10/09| KW AS-BUILT C-10 APPROVAL STAMP:

THE DRAWING AND DESIGN HEREIN SHALL NOT BE DUPLICATED,

ENGINEERING CONSULTANTS:

CUSTOMER'S NAME & ADDRESS

25821 Industrial Boulevard, Suite 300 Hayward, California 94545-2991 Tel (510) 783-6000 Fax (510) 293-2100 California State C10 License No. 758796 U.L. Certificate ID No. 324787-001

JOB NAME & LOCATION (STREET ADDRESS)

LAWRENCE BERKELEY NATIONAL LABORATORY

> BERKELEY LAB **GUEST HOUSE**

Berkeley, California

SHEET CONTENTS:

INSTALLATION TYPE NEW INSTALLATION

DESIGN/BUILD PER CONTRACT DOCUMENT EXISTING BASE JOB # ____ OTHERS _

SYSTEM SALES REP.: PROJECT MANAGER: DRAWN BY: CAD FILENAME: SCALE:

JOB NUMBER DRAWING NO. 6B23E004 44OP-048653